
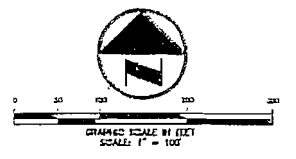
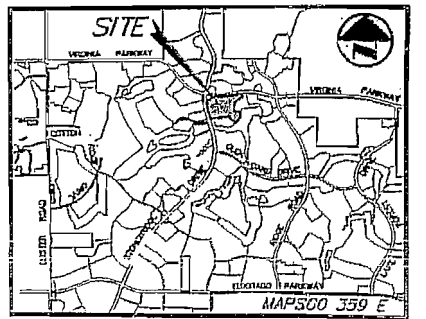


THESE DESIGNATIONS & REVISIONS WERE MADE BY THE ENGINEER BASED ON THE RECORD SURVEY AND RECORDS OF THE PROJECT AND/OR OTHER RECORDS. THE ENGINEER HAS CONDUCTED VISUAL INSPECTIONS OF THE PROJECT AND/OR OTHER RECORDS AND HAS CONDUCTED VISUAL INSPECTIONS OF THE PROJECT AND/OR OTHER RECORDS. THE ENGINEER HAS CONDUCTED VISUAL INSPECTIONS OF THE PROJECT AND/OR OTHER RECORDS.

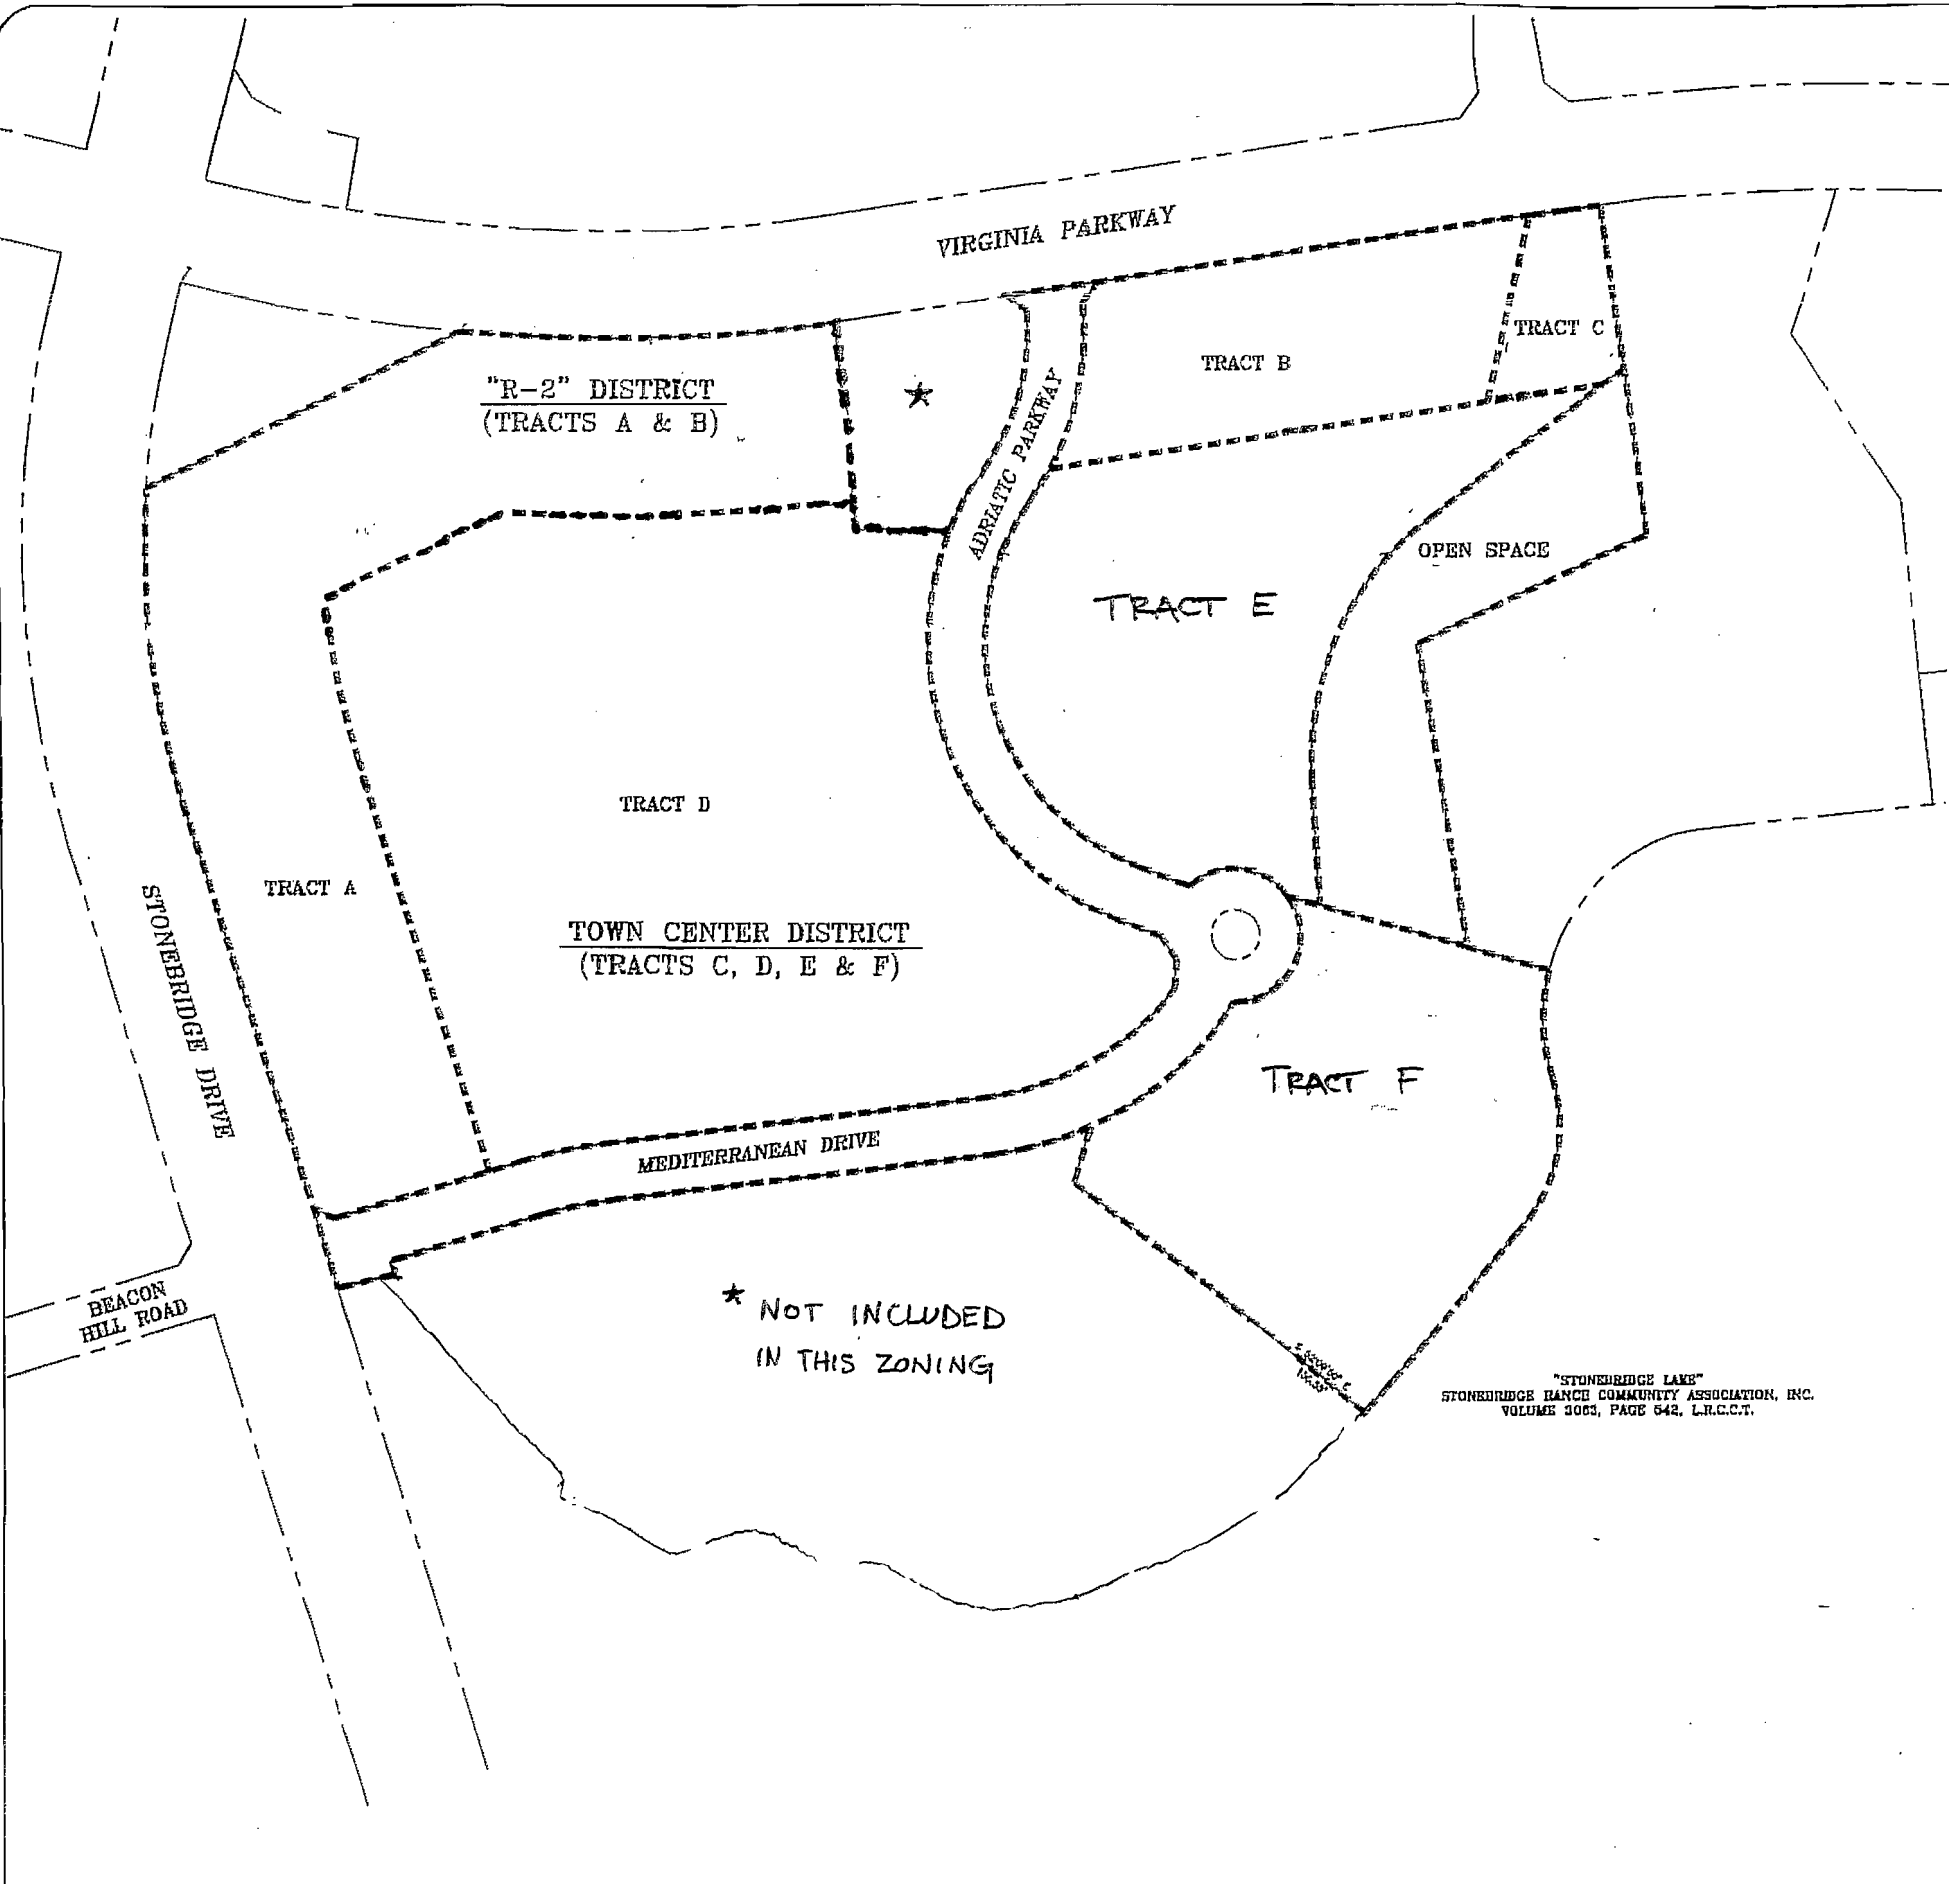

"STONEBRIDGE LAKE"
 STONEBRIDGE RANCH COMMUNITY ASSOCIATION, INC.
 VOLUME 3063, PAGE 642, L.R.C.C.T.

REVISED
 OCT 19 2010
 PLANNING

NO.	DATE	REVISION / DESCRIPTION
DESIGN	DRAWN	DATE
RPP	BEC	AS SHOWN

OWNER/DEVELOPER
 SB HARBOR MARKET JOINT VENTURE
 an affiliated company of:
 BLACKARD GROUP
 5385 ELDORADO PARKWAY
 FRISCO, TEXAS 75034
 MR. JEFFORY D. BLACKARD
 (972) 688-0200 PHONE
 (972) 688-0207 FAX

PROJECT INFORMATION
 ADRIATICA
 a Creative Village at Stonebridge Ranch
 CITY OF MCKINNEY, COLLIN COUNTY, STATE
 J.R. GRAY SURVEY, ABSTRACT NO. 343
 J.R. GRAY SURVEY, ABSTRACT NO. 344
 HENRY JOHNSON SURVEY, ABSTRACT NO. 482
 ZONING: PD# 2005-02-017
 PD# 2003-12-117

POGUE
 ENGINEERING & DEVELOPMENT COMPANY, INC.
 1516 HERITAGE DRIVE SUITE 102 MCKINNEY, TEXAS 75069
 (214) 544-0000 PHONE (214) 544-0002 FAX

ZONING EXHIBIT
 ADRIATICA AT STONEBRIDGE
 SEC VIRGINIA PARKWAY @ STONEBRIDGE DRIVE
 J.R. GRAY SURVEY, ABSTRACT NO. 343
 CITY OF MCKINNEY, TEXAS

SHEET NO.
 20.01