


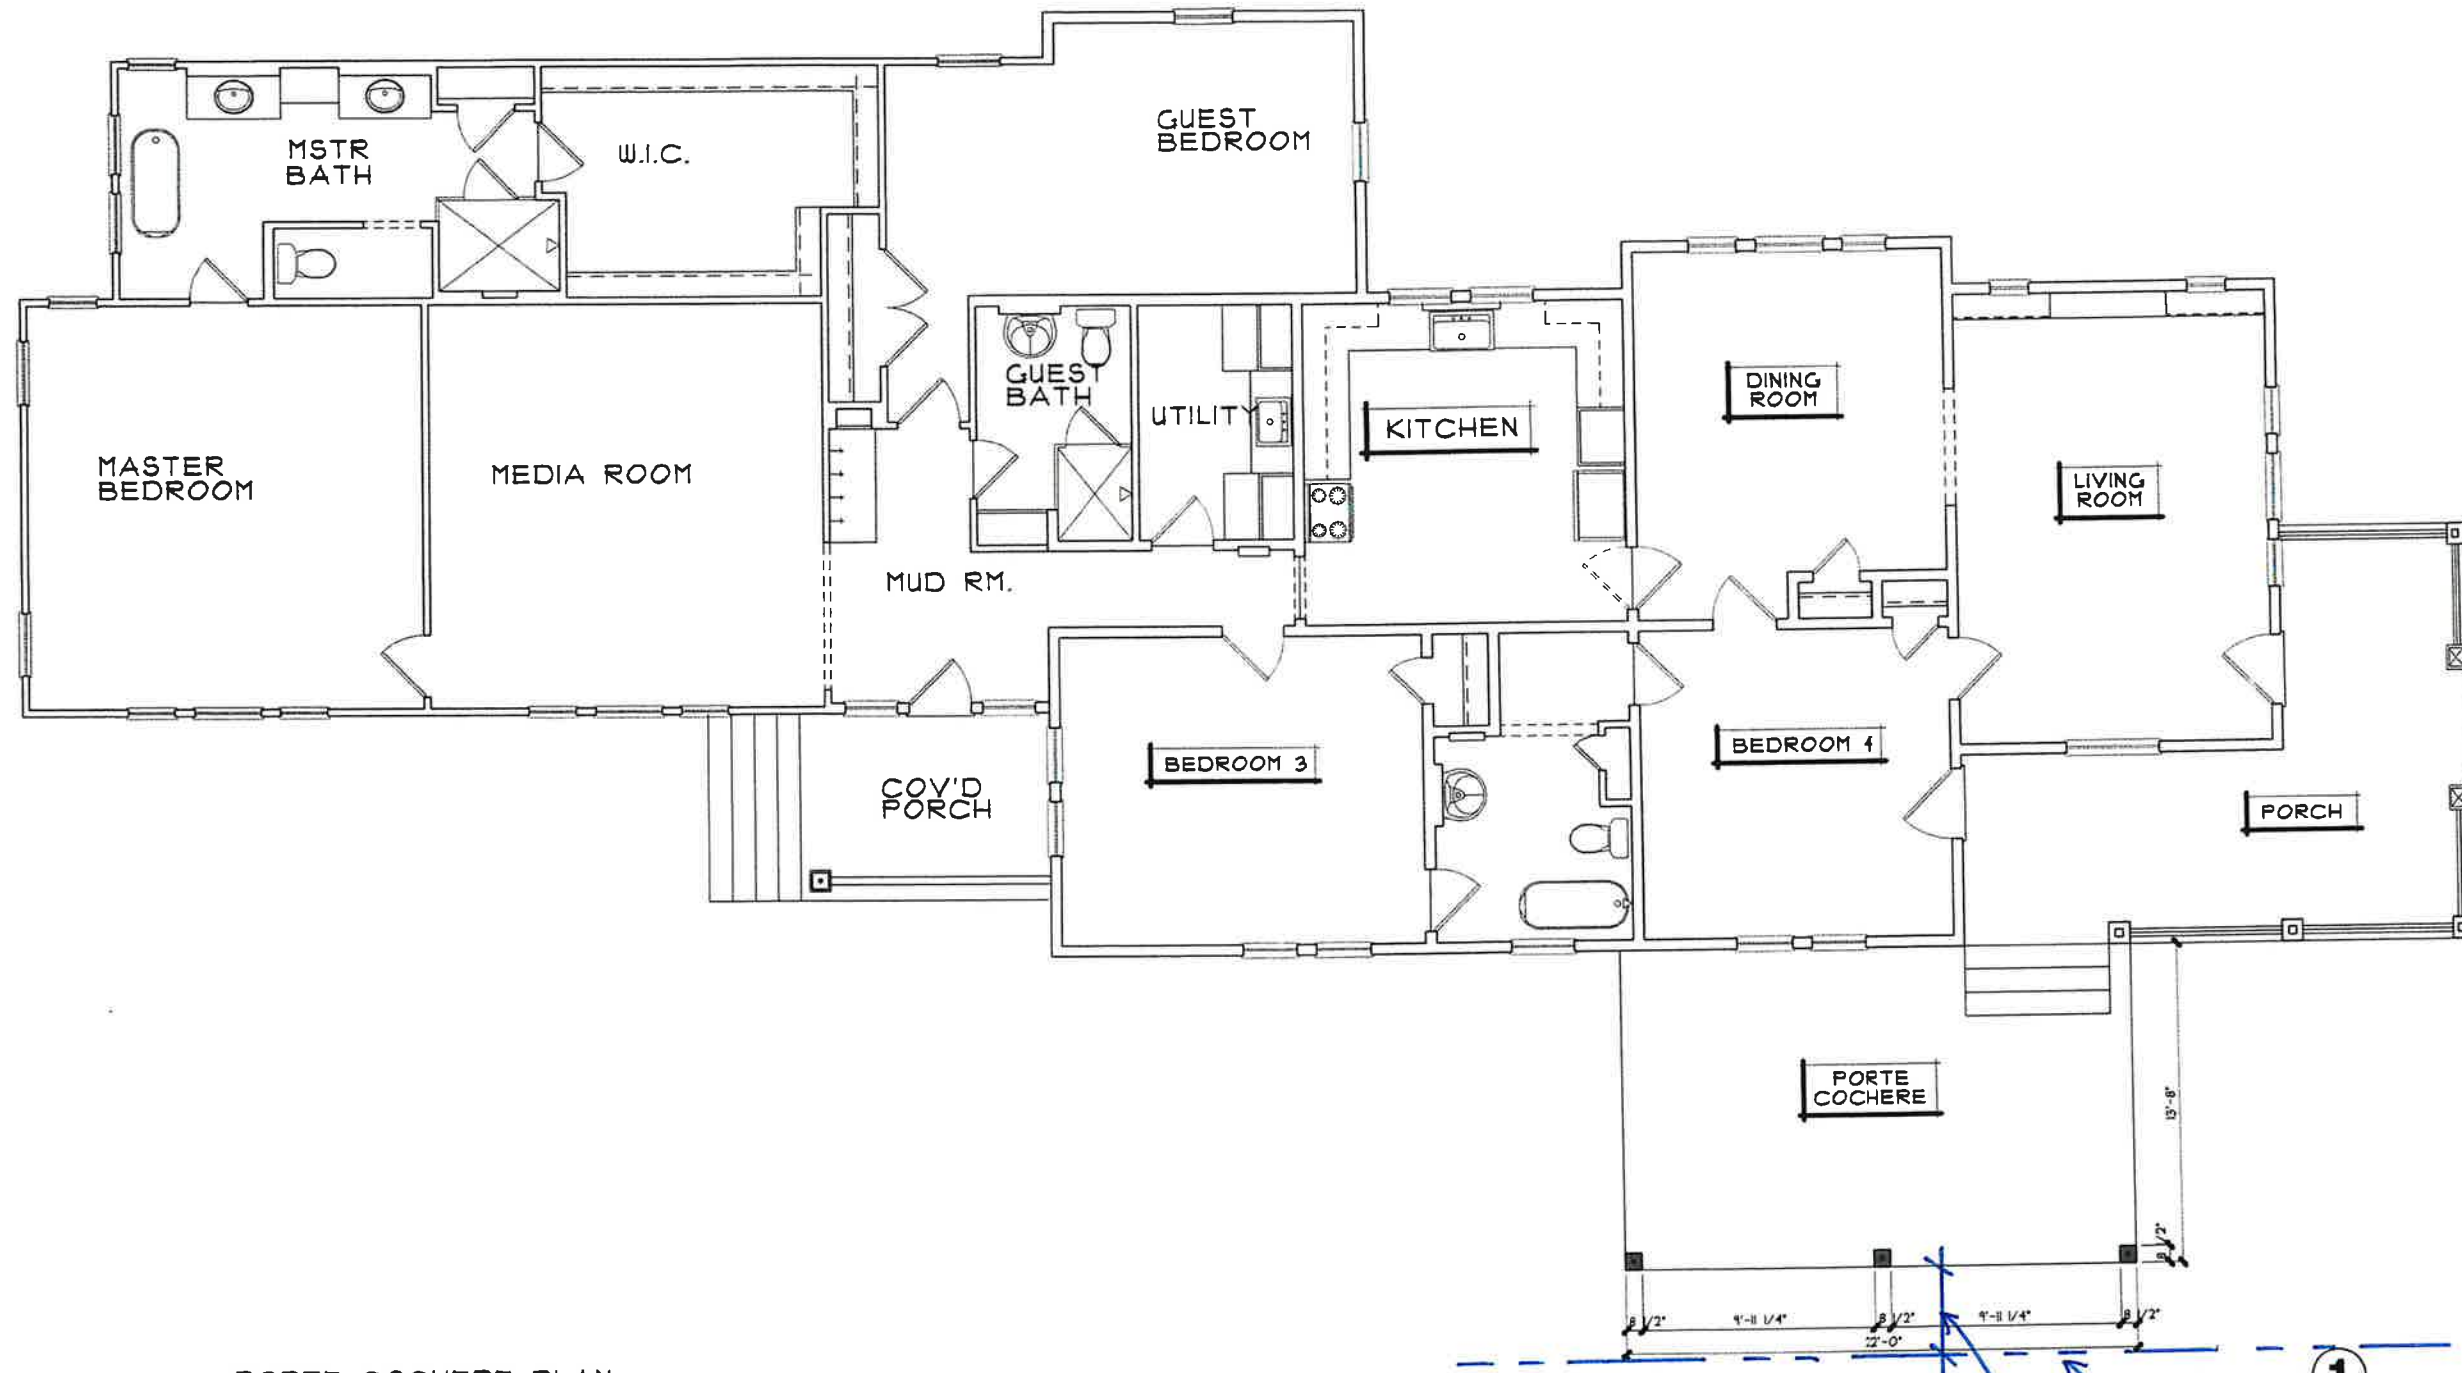

PORTE COCHERE PLAN
SCALE: 1/4" = 1'-0"

Property Line
3'-8"
Setback
from
Property
Line

McREYNOLDS DESIGNS

NEW HOMES • REMODELS • RENOVATIONS

214-551-5014 mark@mcreynoldsdesigns.com

Revision:

THIS IS AN ORIGINAL, UNPUBLISHED WORK AND MAY NOT BE DUPLICATED, PUBLISHED, OR OTHERWISE USED WITHOUT WRITTEN CONSENT OF MARK McREYNOLDS © 2021

MAIN LEVEL
PLAN

FOR THE CONSTRUCTION OF THIS PROJECT, THE DESIGNER HAS REVIEWED THE EXISTING RECORD DRAWINGS AND ALL INFORMATION PROVIDED BY THE CLIENT. THE DESIGNER HAS CONDUCTED A VISUAL GENERAL VERIFICATION OF THE INFORMATION PROVIDED AND HAS FOUND IT TO BE SUFFICIENT FOR THE PRELIMINARY DESIGN. THE DESIGNER HAS NOT CONDUCTED A SURVEY OF THE PROPERTY AND HAS NOT OBTAINED ANY RECORD DRAWINGS. THE DESIGNER HAS NOT CONDUCTED A SURVEY OF THE PROPERTY AND HAS NOT OBTAINED ANY RECORD DRAWINGS. THE DESIGNER HAS NOT CONDUCTED A SURVEY OF THE PROPERTY AND HAS NOT OBTAINED ANY RECORD DRAWINGS.

Date 11-05-21

An Addition To:
The Sammons Residence
Location:
1005 W. Hunt Street
McKinney, TX

A3